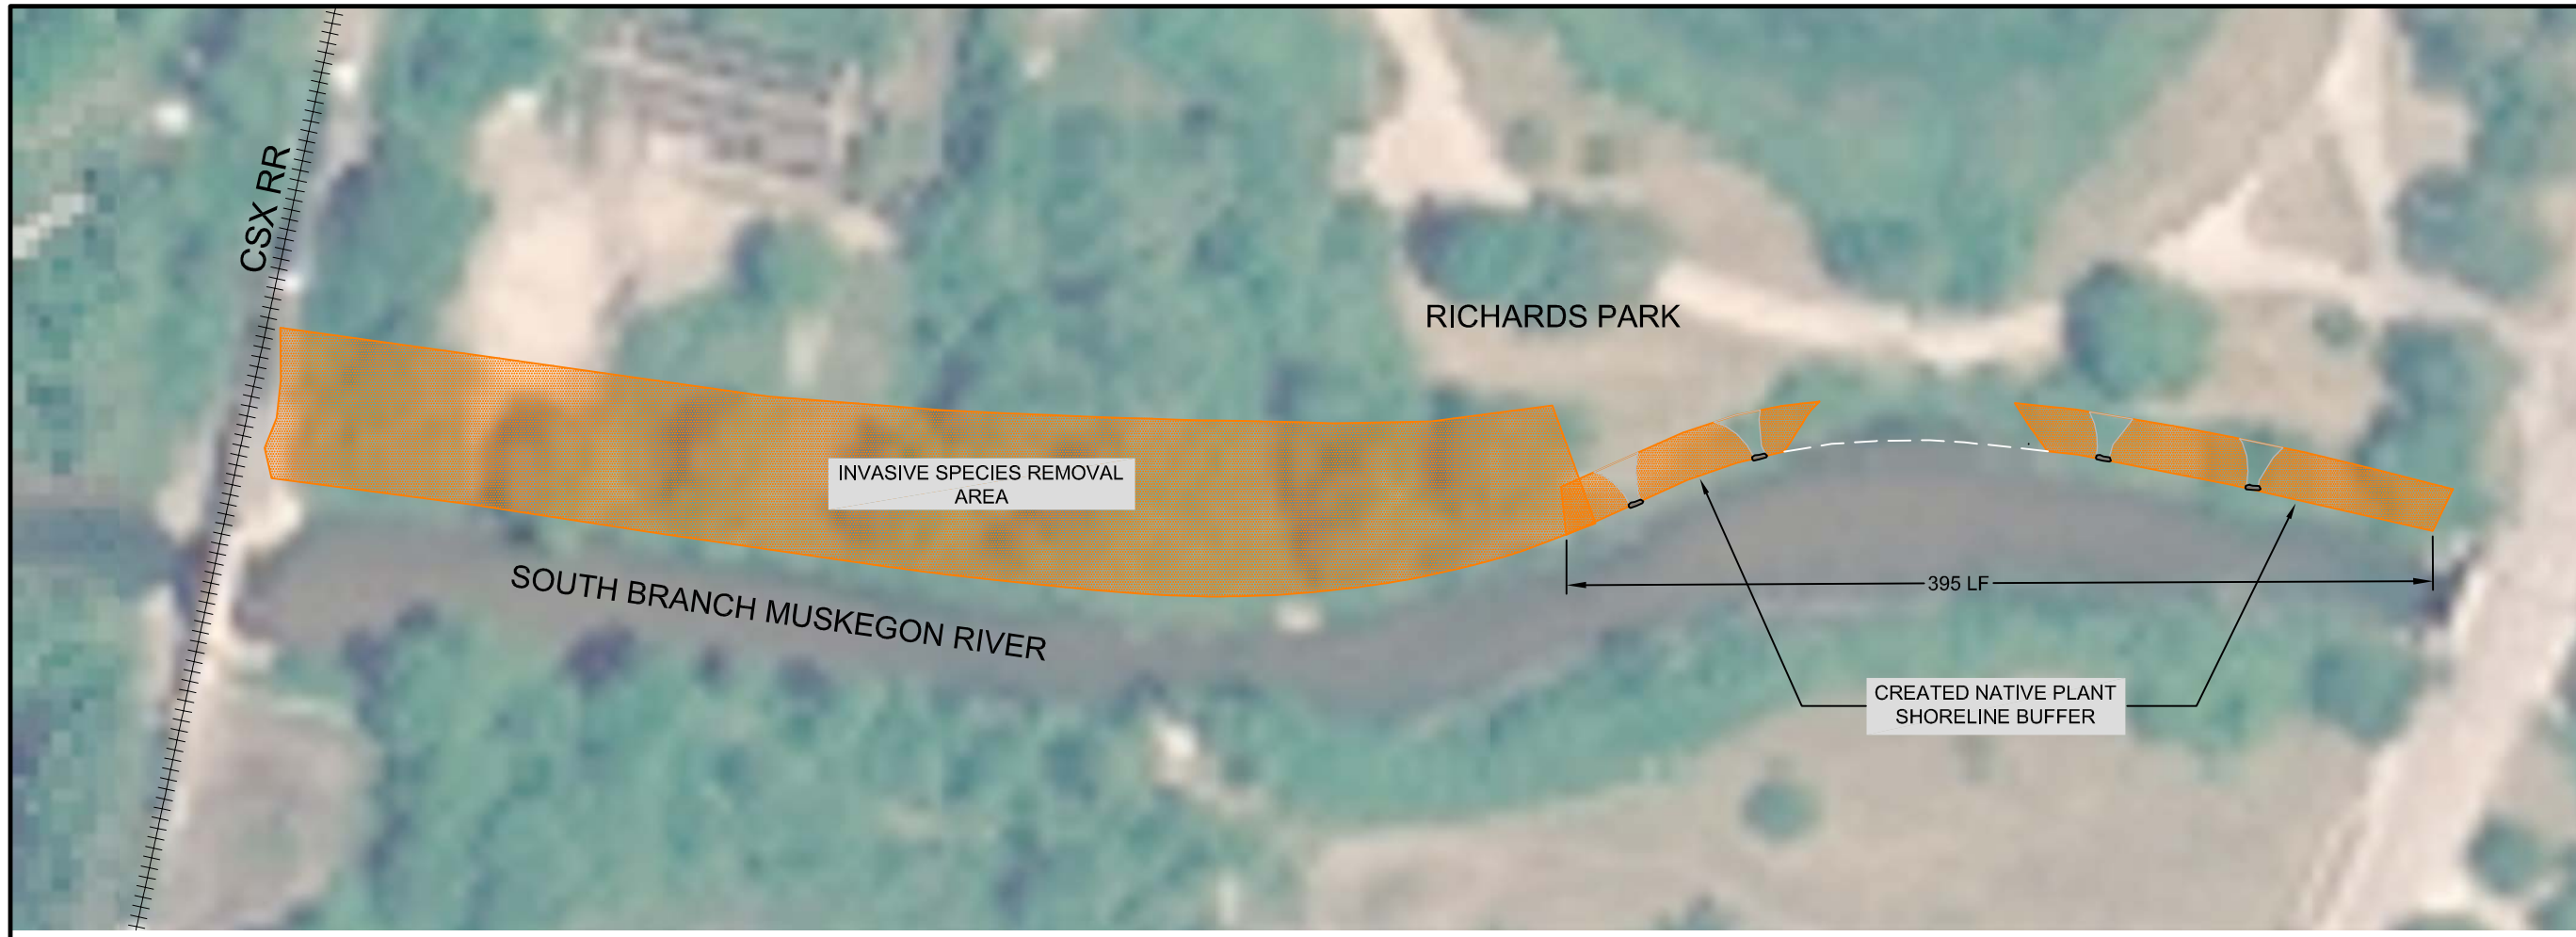

Site Vicinity Map

RESTORATION SUMMARY: RICHARDS PARK

LINEAR FEET OF SHORELINE SOFTENING	WETLAND/STREAM BUFFER RESTORATION
395	8.59 AC

NOTE: QUANTITIES, AREAS, AND DISTANCES ARE BASED UPON FINAL DESIGN SPECIFICATIONS.

LEGEND

SHORELINE BUFFER (UPLAND) RESTORATION AND INVASIVE SPECIES REMOVAL

N

0 40'

Cardno JFNew

Corporate/Northern Indiana
708 Roosevelt Road
Walkerton, Indiana 46574
574-586-3400

Western Michigan
11181 Marwill Avenue
West Olive, Michigan 49460
616-847-1680

REVISION

Richards Park Shoreline Enhancement As-Built Plan

West Michigan Shoreline Regional Development Commission and the Muskegon Lake Watershed Partnership

DRAWN BY:	RAB
DESIGNED BY:	BM/KR
DATE:	August, 2012
JOB NUMBER:	0902035

FIGURE

1

RECOVERY.GOV

NOAA NATIONAL OCEANIC AND ATMOSPHERIC ADMINISTRATION U.S. DEPARTMENT OF COMMERCE

MUSKEGON CONSERVATION DISTRICT

MLWP Muskegon Lake Watershed Partnership

WMSRDC WEST MICHIGAN SHORELINE REGIONAL DEVELOPMENT COMMISSION

Great Lakes Commission des Grands Lacs